


Deed # J.M. Deaton & wife, Mary Deaton, and the Swann-Day Lumber Co. to L. & E. Ry. Co. - Feb. 26, 1911 - Cons. # 2100.
 Deed covers two strips of land.
 Strip: - R.W. 50' each side E, begin at L.L. bet granors and Carl Spicer at or near Const. Sta. 722+30; thence up river 2520± to L.L. bet granors and Ky Union Co. Cont. 6.A.± Ry. Co. to make and maintain a crossing at or near the point where granors road leading to the upper Cove field on granors farm crosses R.R. Recorded in D.B. 30, P. 414-415-416 & 417.

Deed # Kentucky Union Co. to L. & E. Ry. Co. - Feb. 21, 1911 - Cons. # 122.
 R.W. 40' each side E; begin at L.L. bet granor and the Jack South heirs at or near Const. Sta. 747+50; thence up river 5199± to L.L. between granor and Wiley & Dan Turner; Cont. 3.5.A.±
 Additional R.W. to protect slopes of cuts, fills & slides @ \$1.00 per A
 Rec. D.B. 31, P. 355, 356, 357 & 358.

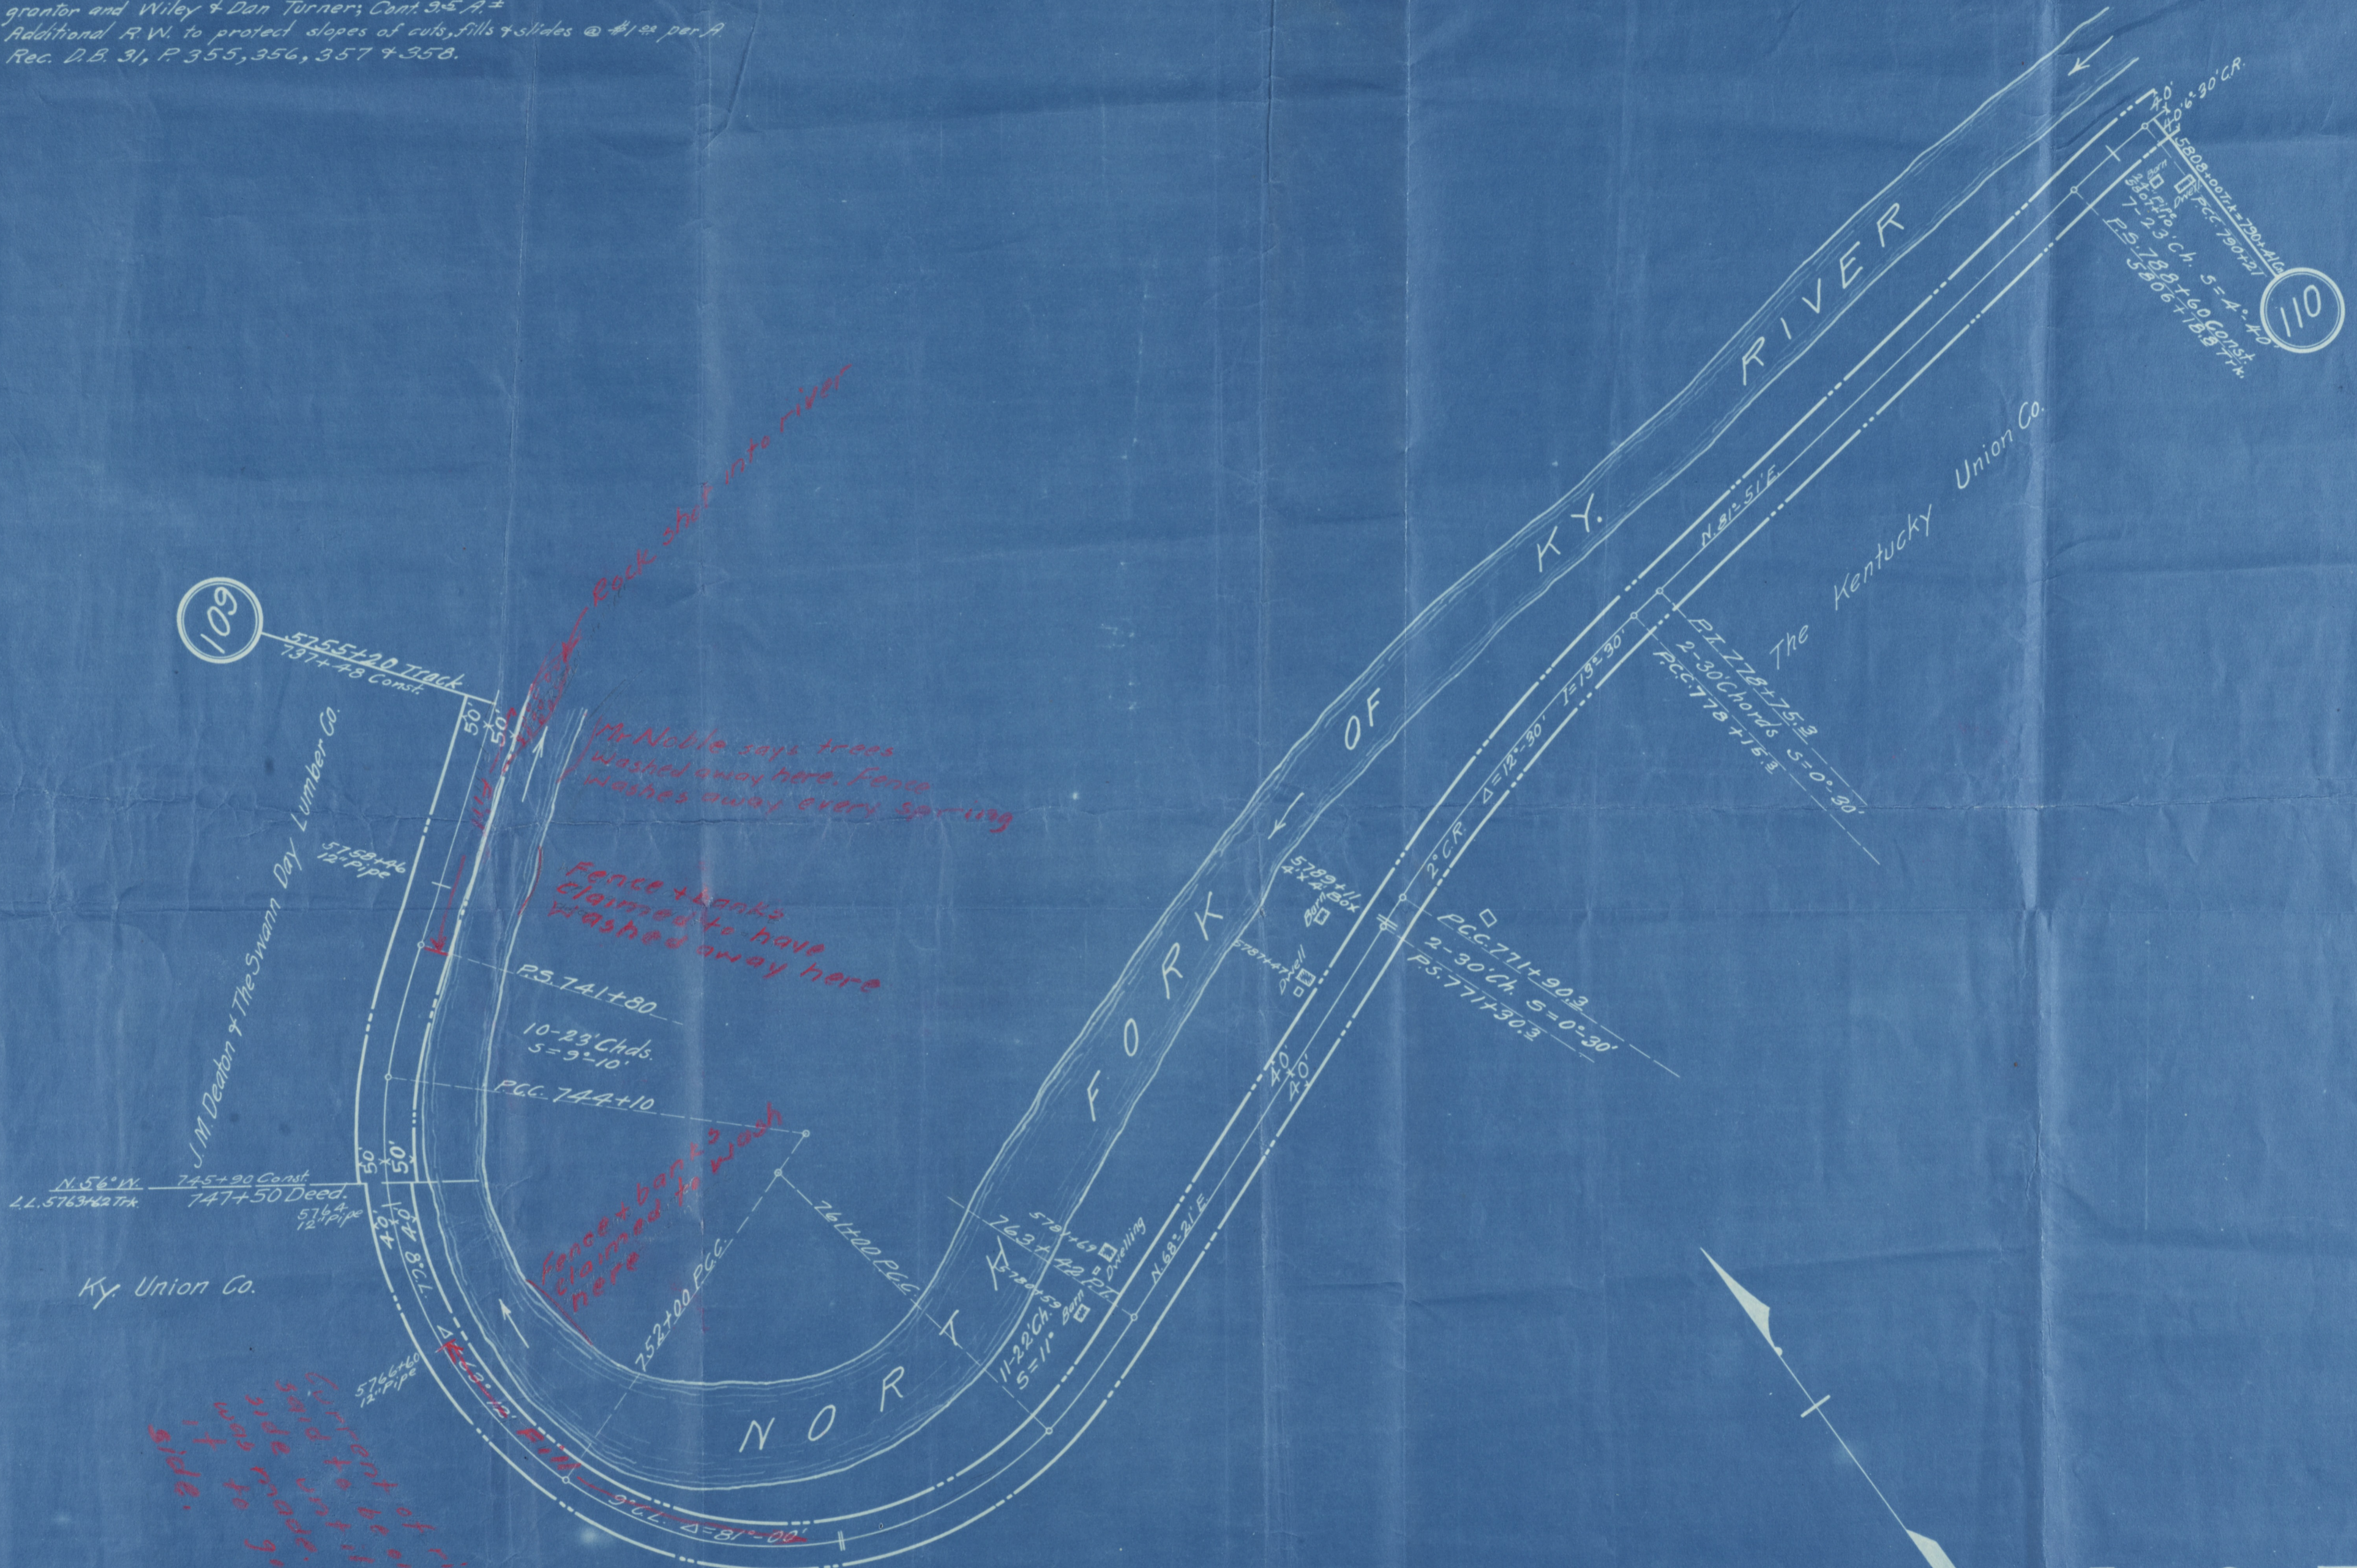

109

110

L. & E.
 MILE 110.

SCALE 1"=200'

SEPT. 1914

Breathitt County, Ky.

